

22 JAN 2001

18.1.01

As built drainage Plan

Constant No ABA 200010017

Owner: Wayne Cantwell, Drainlayer: Tony Farrell


Address 84 Kauri Pt Rd, Langhorne.

Lot: 384 DP: 17523

Road

Inspected 15/1/01
J. Mitchell

Prop. 51002

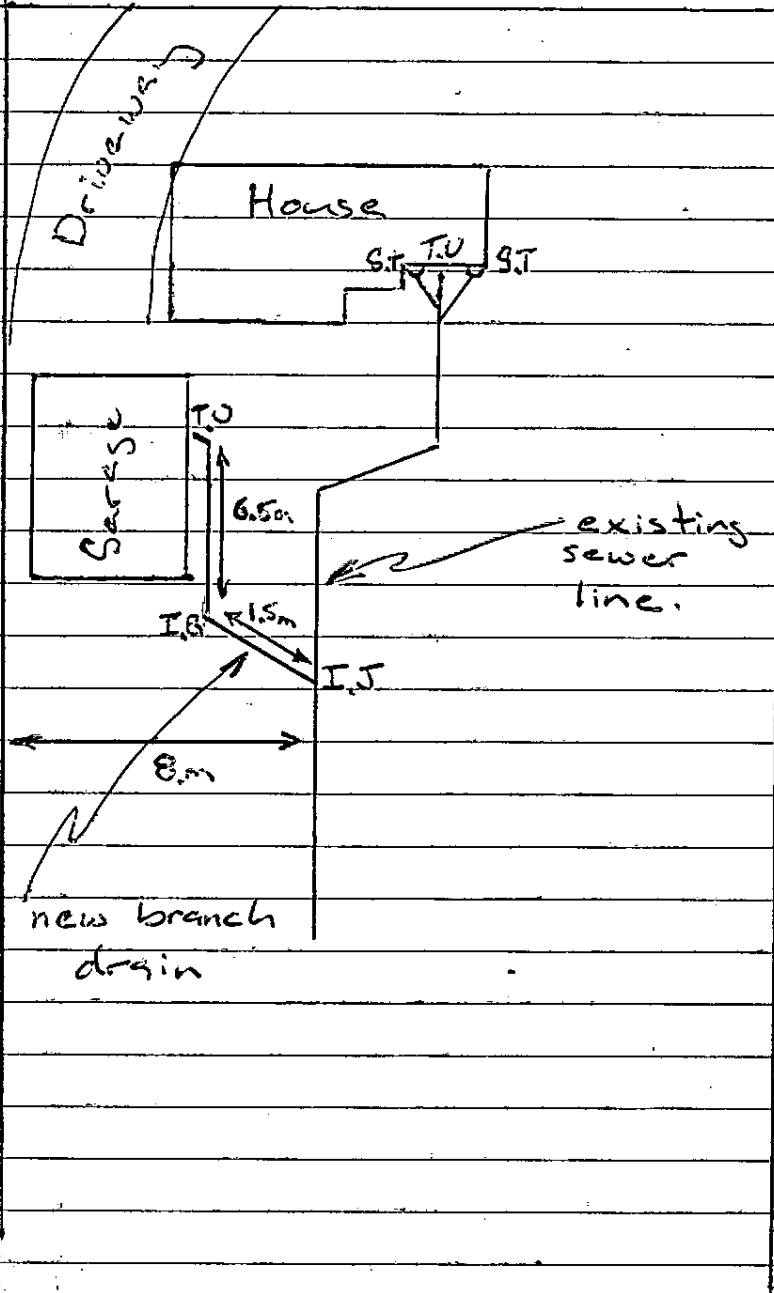

84 Kauri Pt Rd

Attention: John Nicholls

Resources
City Infrastructure
Maori Issues
Consent Sec